


FLOOR PLANS

SUITE 200
4,000 - 7703 SF

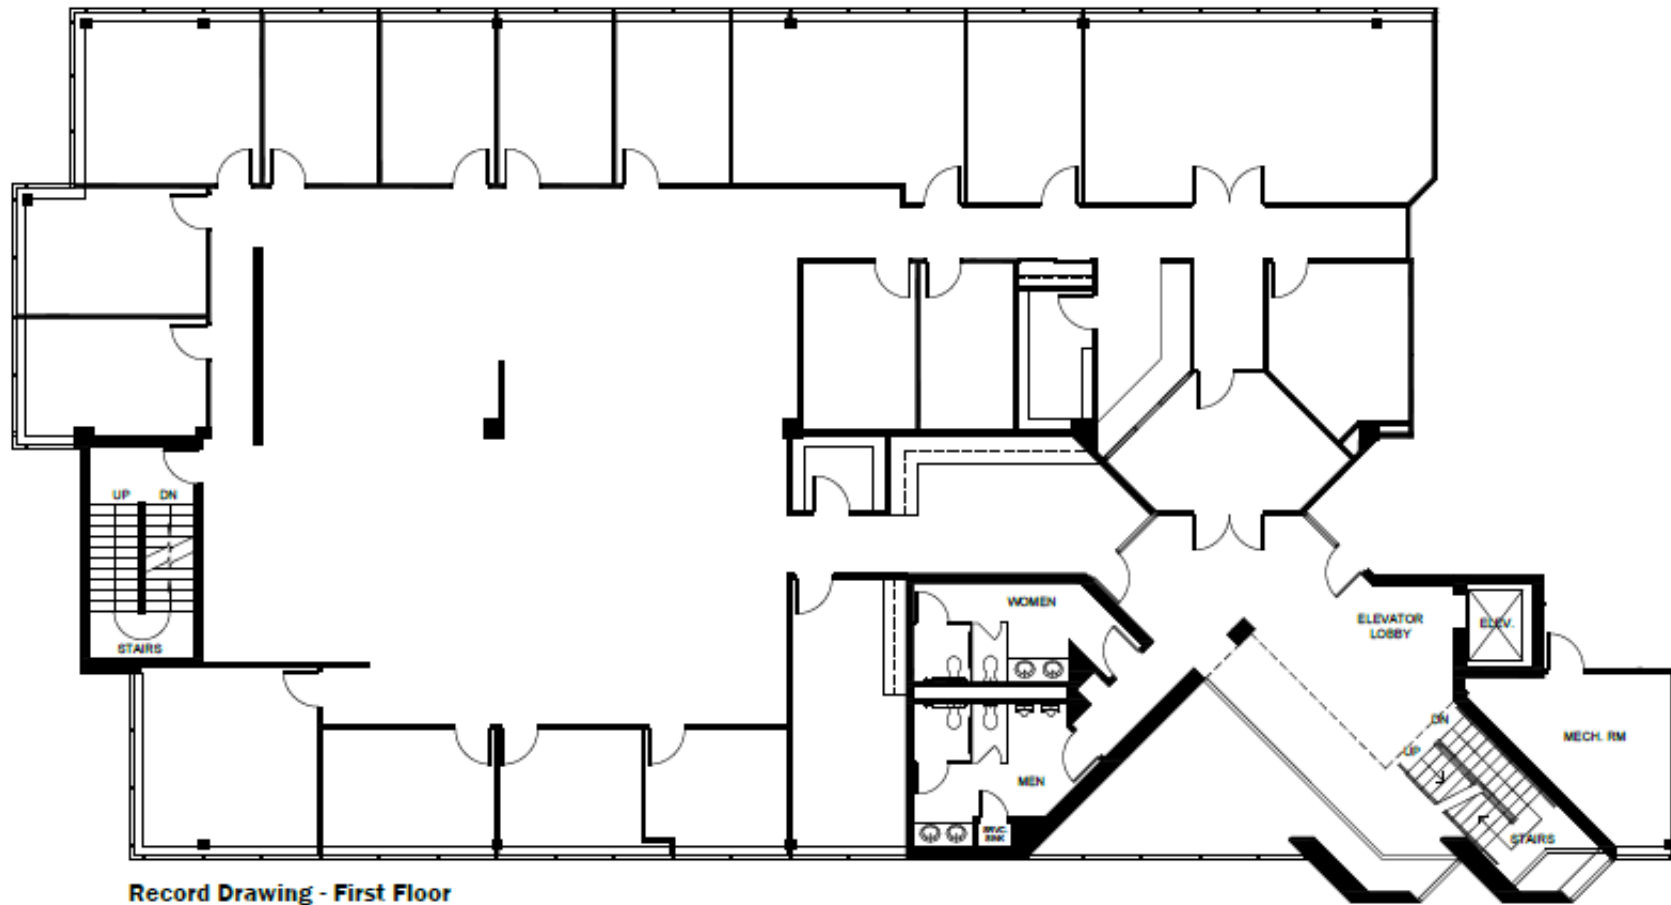

Record Drawing - First Floor
Scale: 1/8" = 1'-0"

The foregoing information was furnished to us by sources which we deem to be reliable, but no warranty or representation is made as to the accuracy thereof. Subject to correction of errors, omissions, change of price, prior sale or withdrawal from market without notice.